


AS-BUILT PLANS 12/12/12

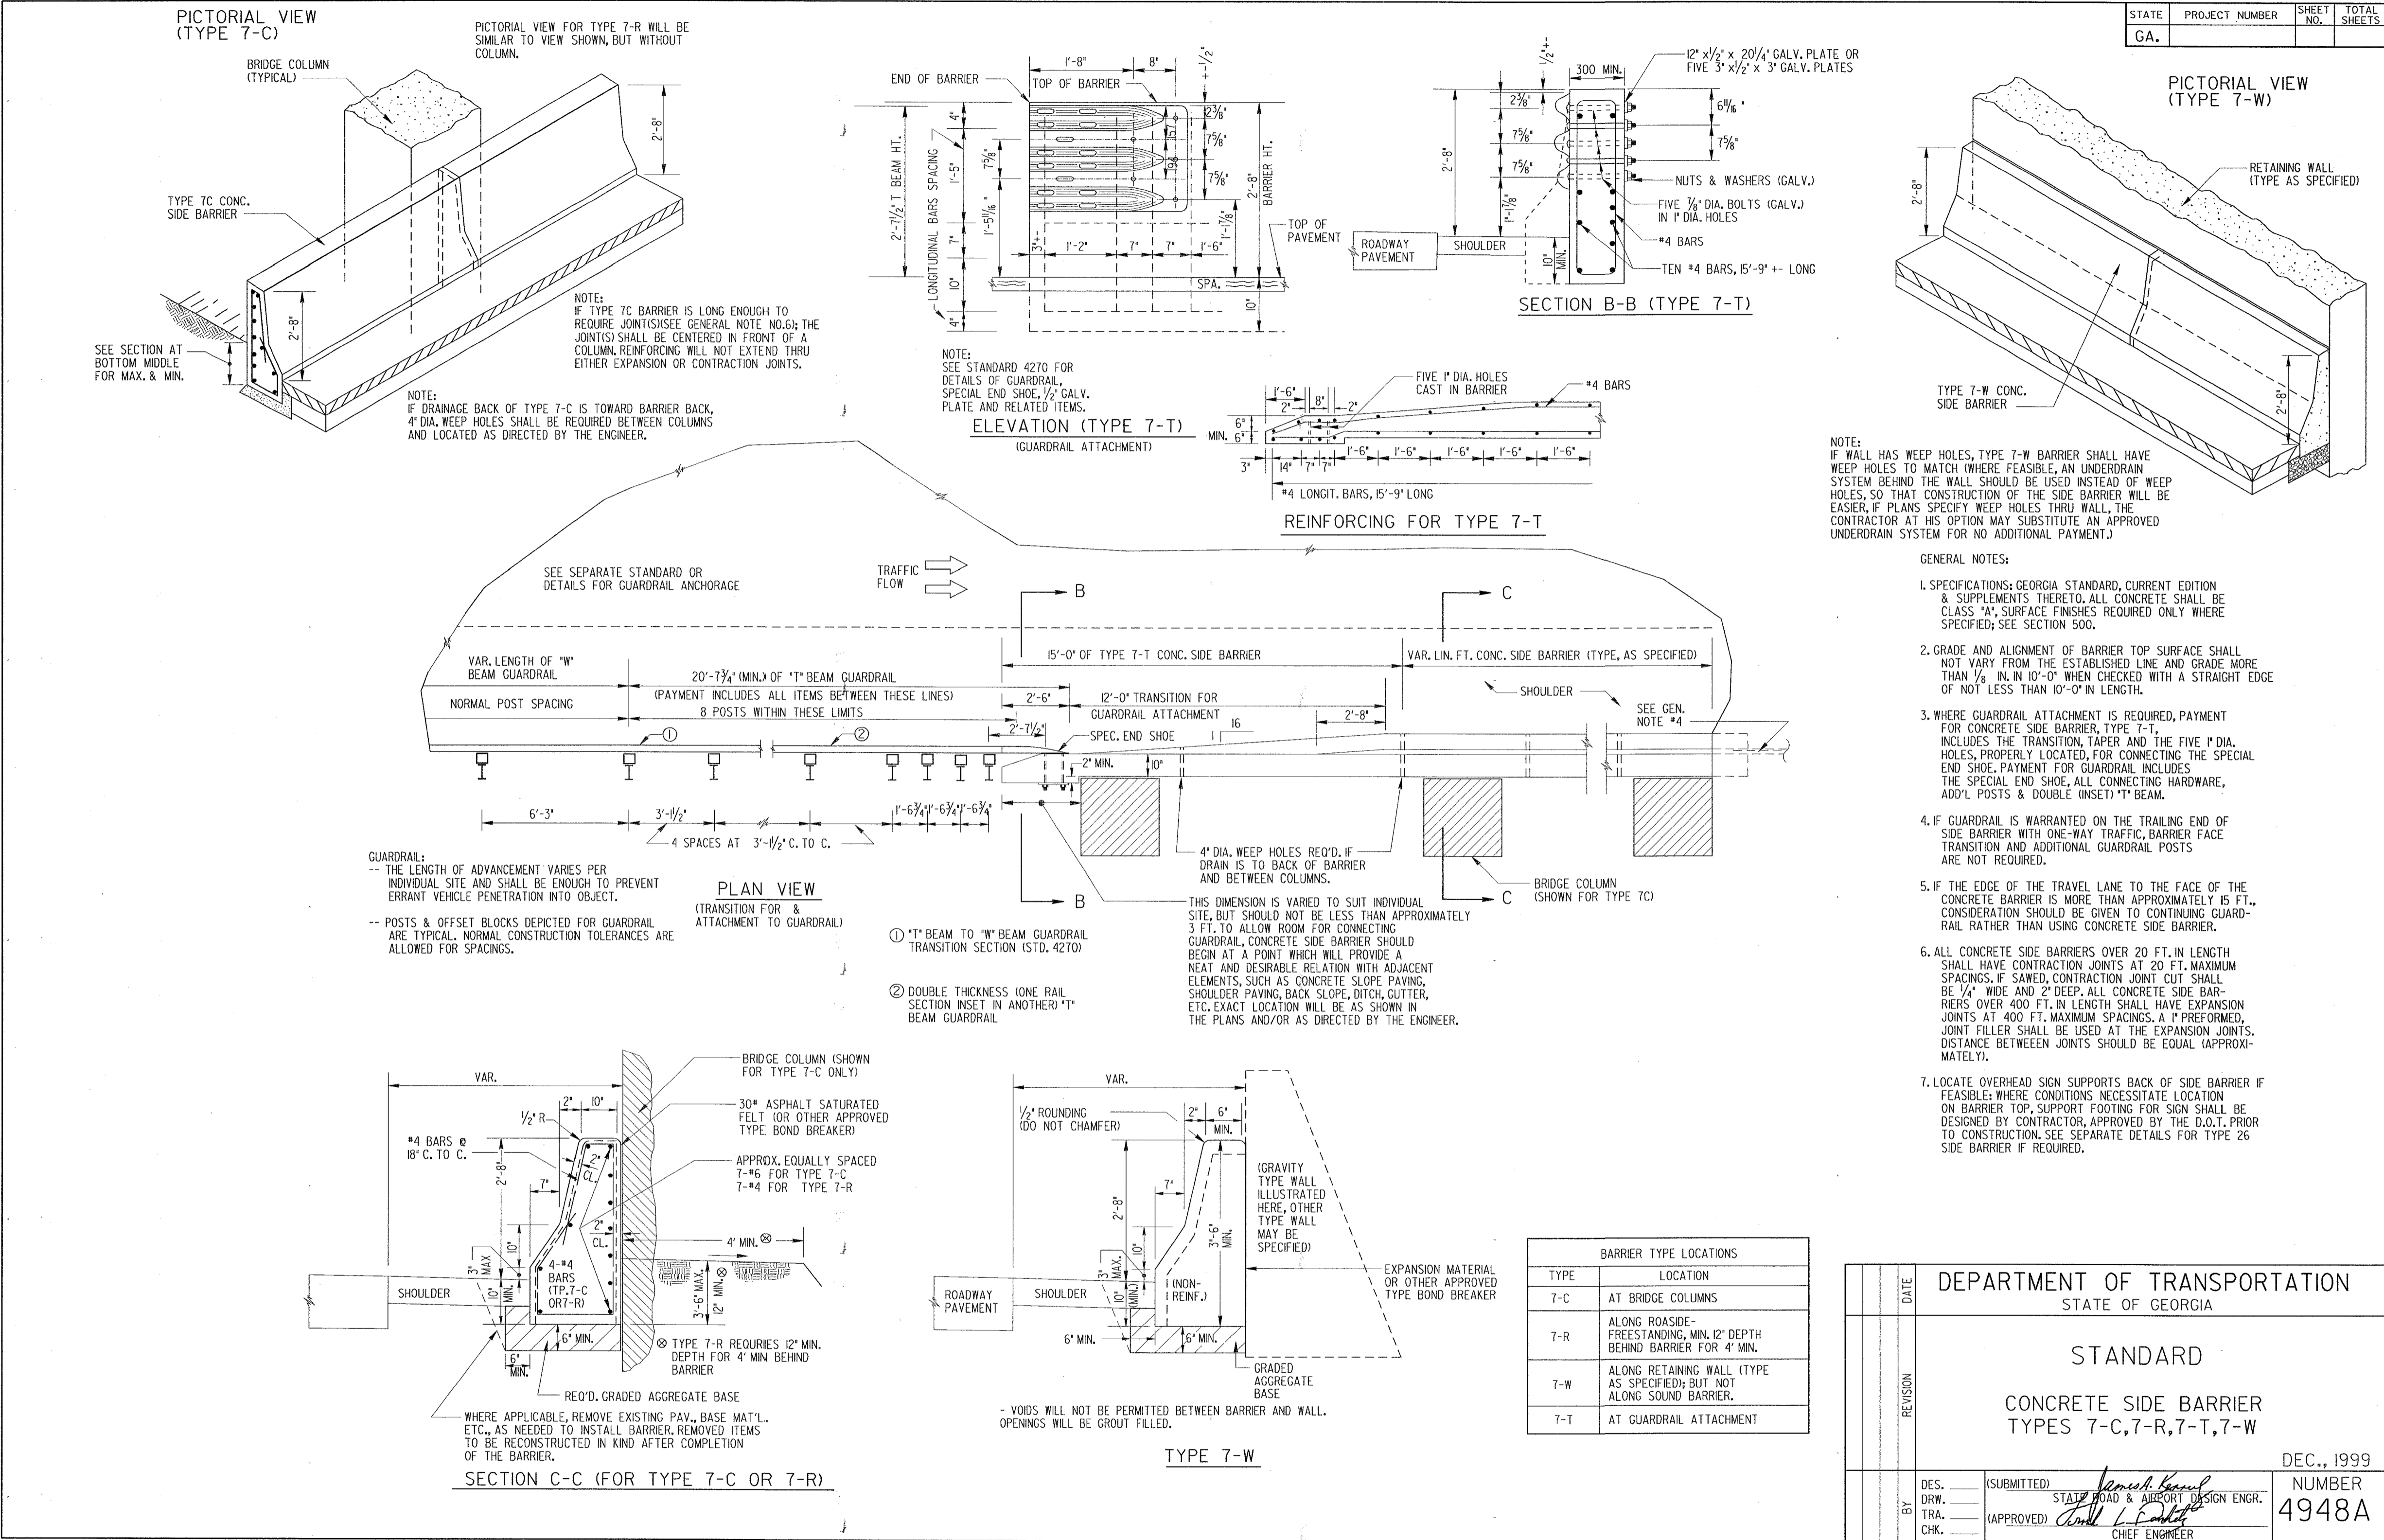

DATE		DEPARTMENT OF TRANSPORTATION STATE OF GEORGIA	
REVISION		STANDARD	
		CONCRETE SIDE BARRIER TYPES 7-C, 7-R, 7-T, 7-W	
BY		DES. _____ DRW. _____ TRA. _____ CHK. _____	(SUBMITTED) _____ (APPROVED) _____ STAT. ROAD & AIRPORT DESIGN ENGR. CHIEF ENGINEER
		DEC., 1999 NUMBER 4948A	

REVISION DATES